
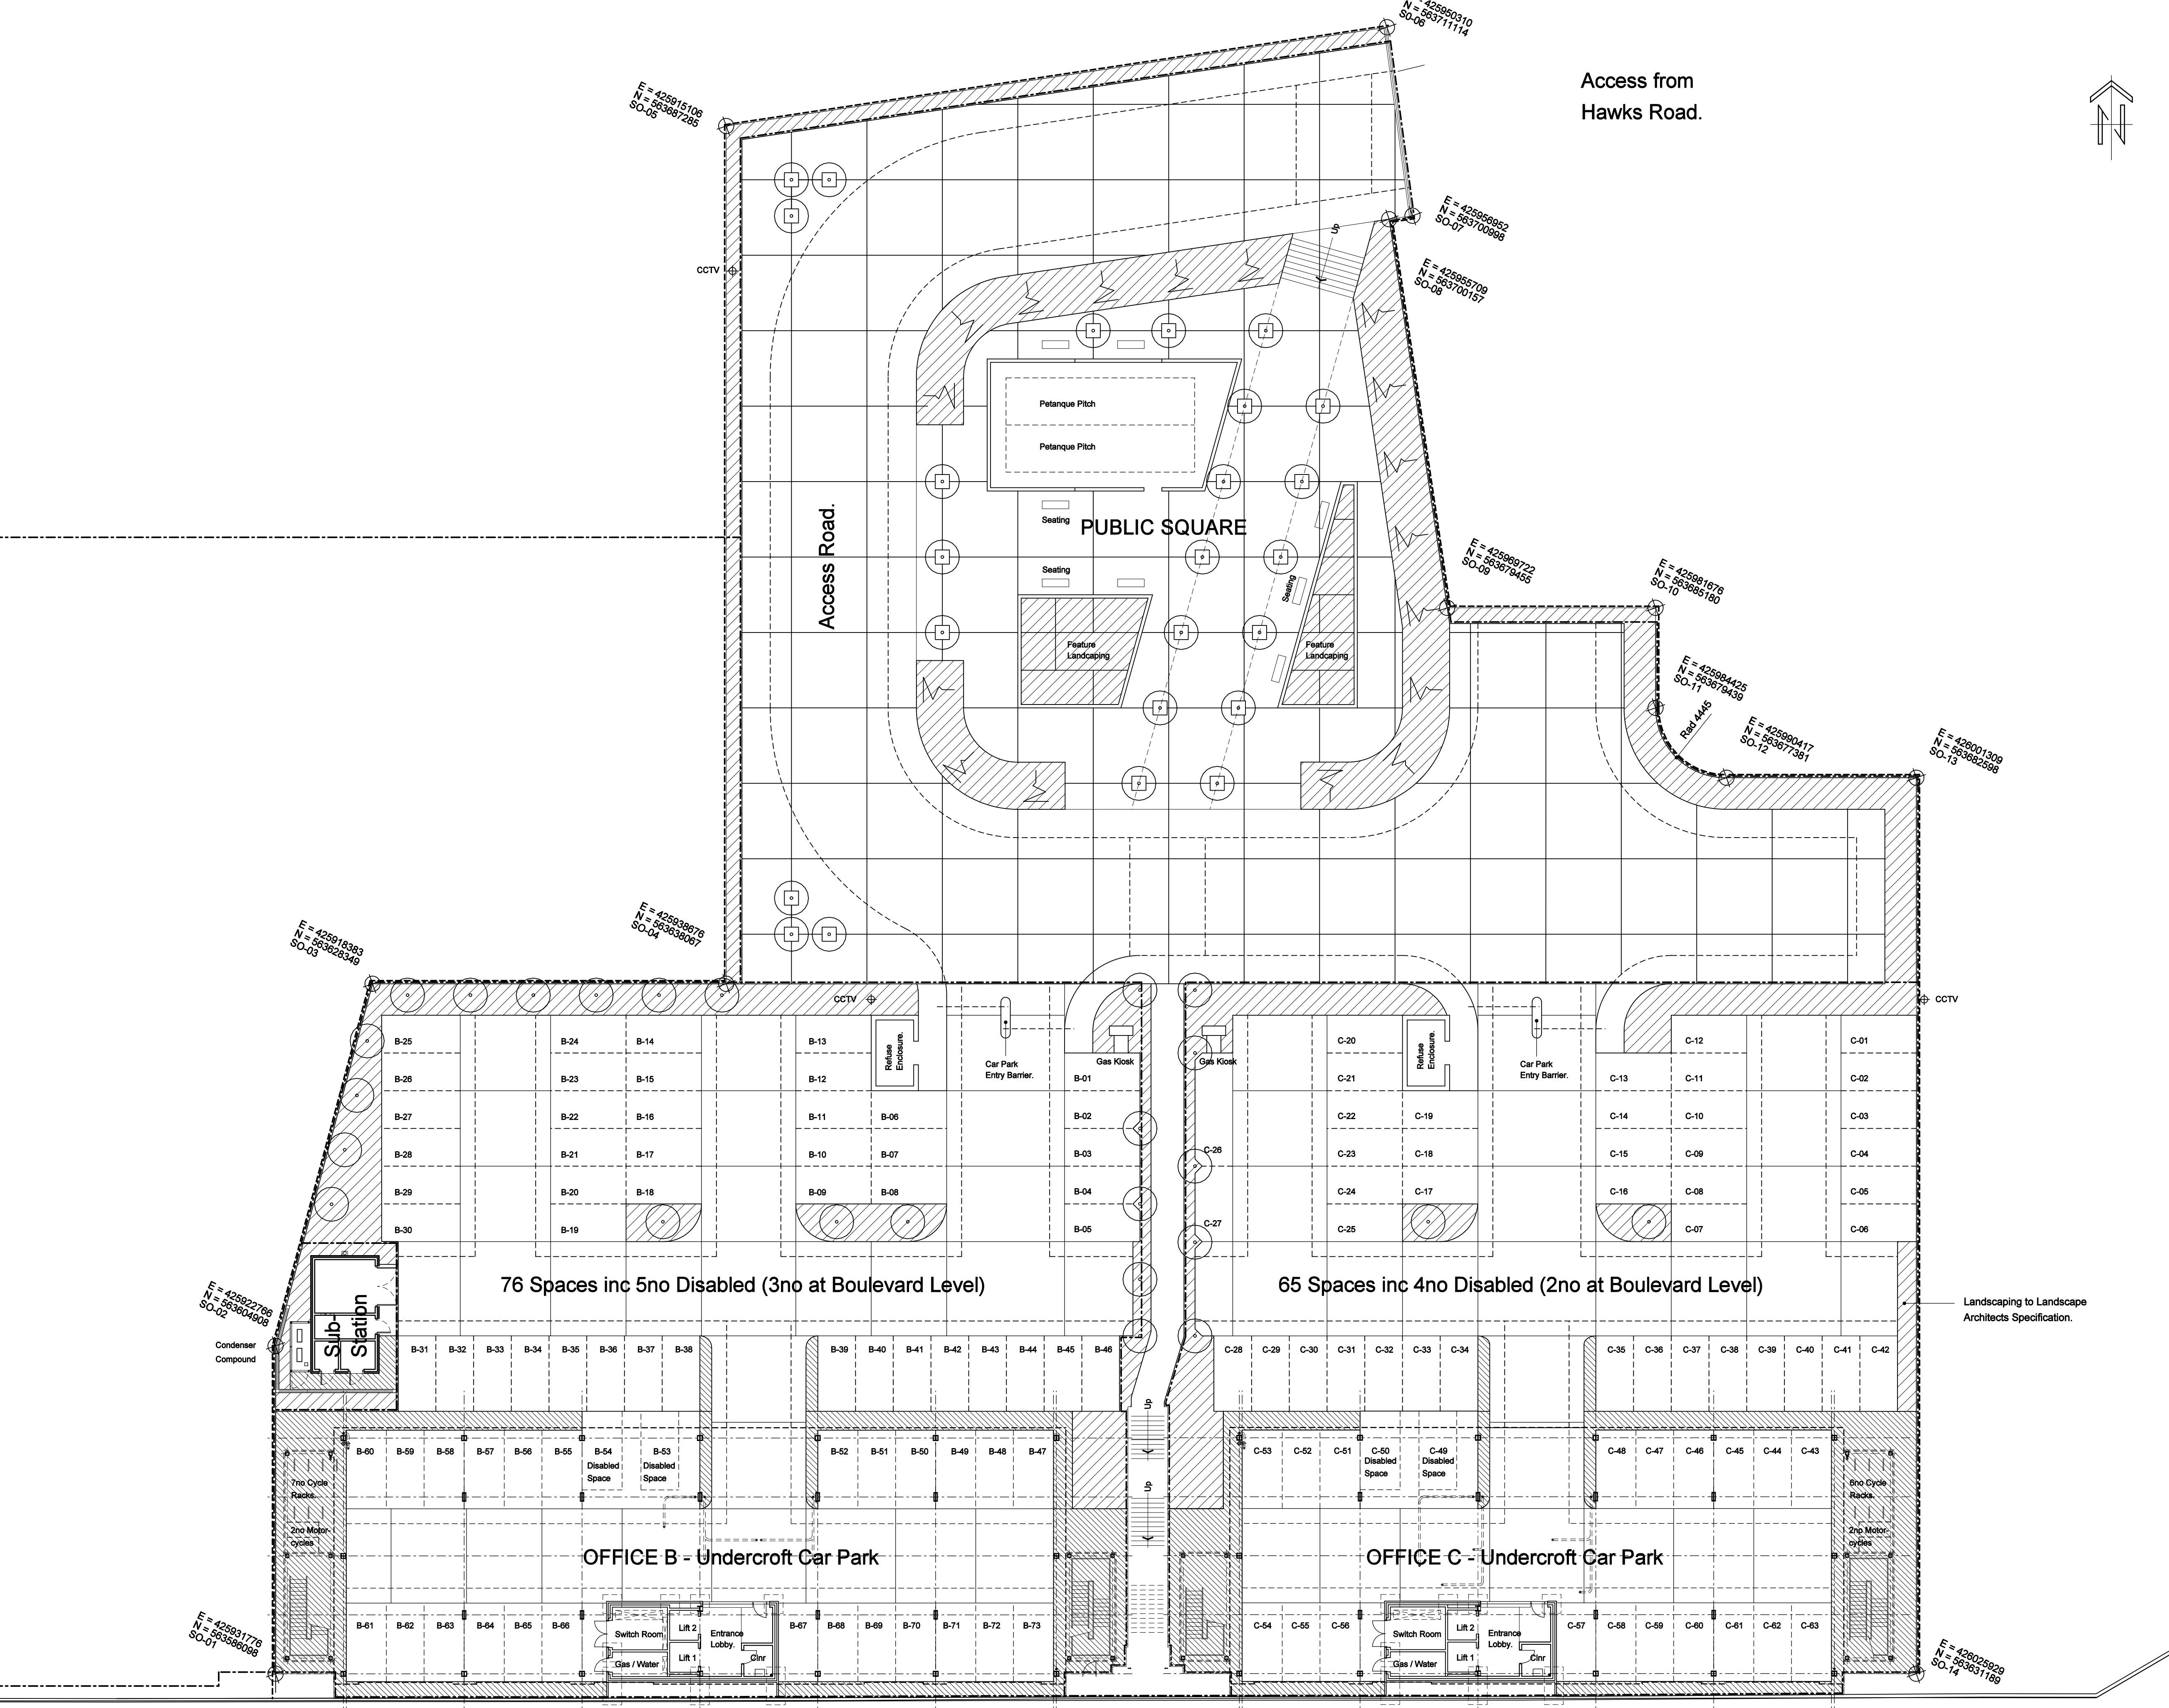


Notes:
 1 - To be read with CDM Risk Register.
 2 - Do not scale, check this is the latest version, if in doubt, ask.
 3 - See drawing issue log for issue history


External Materials:
 Public Square and Access Road -
 Marshalls Mistral textured paving with
 Marshalls Caithness Riven Stone feature bands.
 Facing Brickwork walls to Feature Landscaping and
 Marshalls Conservation Kerbs to edging.
 Marshalls Sineu Graff Bollards to Access Road/Public Square.

Office Car Parking:
 Road - Marshalls Keyblok Grey with Charcoal markings.
 Pedestrian Routes - Keyblok Grey with Charcoal markings.
 Parking Spaces - Keyblok Charcoal with Grey Markings.
 Paving - Marshalls Riatta.
 Marshalls Conservation Kerbs to edging.
 Disable Logo's - Marshalls Colourtop White Keybloks.

Notes:
 1 - Keybloks to be laid stretcher bond with 200mm soldier course to perimeter.
 2 - Refer to Landscape Architect Drawings for Landscaping Design.
 3 - Refer to Engineers Drawings for external works details.

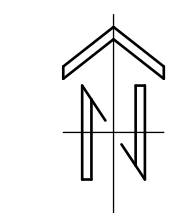

P	CONDENSER COMPOUND INDICATED.	R	18.03.10	MD	-
N	RECORD DRAWING.	R	30.06.08	MD	-
revision	description	status	date	author	reviewer

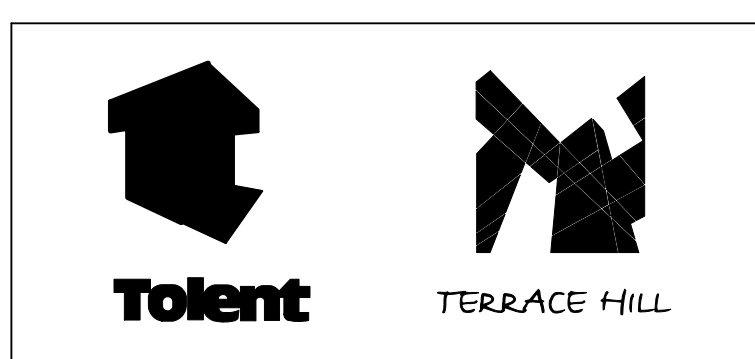

redboxarchitecture

Red Box Architecture, 1 Pioneer Court, Morton Palms, Darlington, DL1 4WB
 t: +44 (0)1325 373188, f: +44 (0)1325 373189, mail@redboxdesign.com, www.redboxdesign.com
 Red Box Design Group Ltd trading as Red Box Architecture
 redboxdesigngroup - redboxinteriors - redboxgallery

Project: Baltic Business Quarter Phase 1 Offices B and C

Drawing: GENERAL ARRANGEMENT Proposed Site Plan

scale	1:200	job no.	04 080	dwg no.	
of size	A1	status	Record	sheet	102 P

copyright © Red Box Design Group Ltd 2008